


1

POOL & POOLHOUSE


SCALE 1/16"=1'

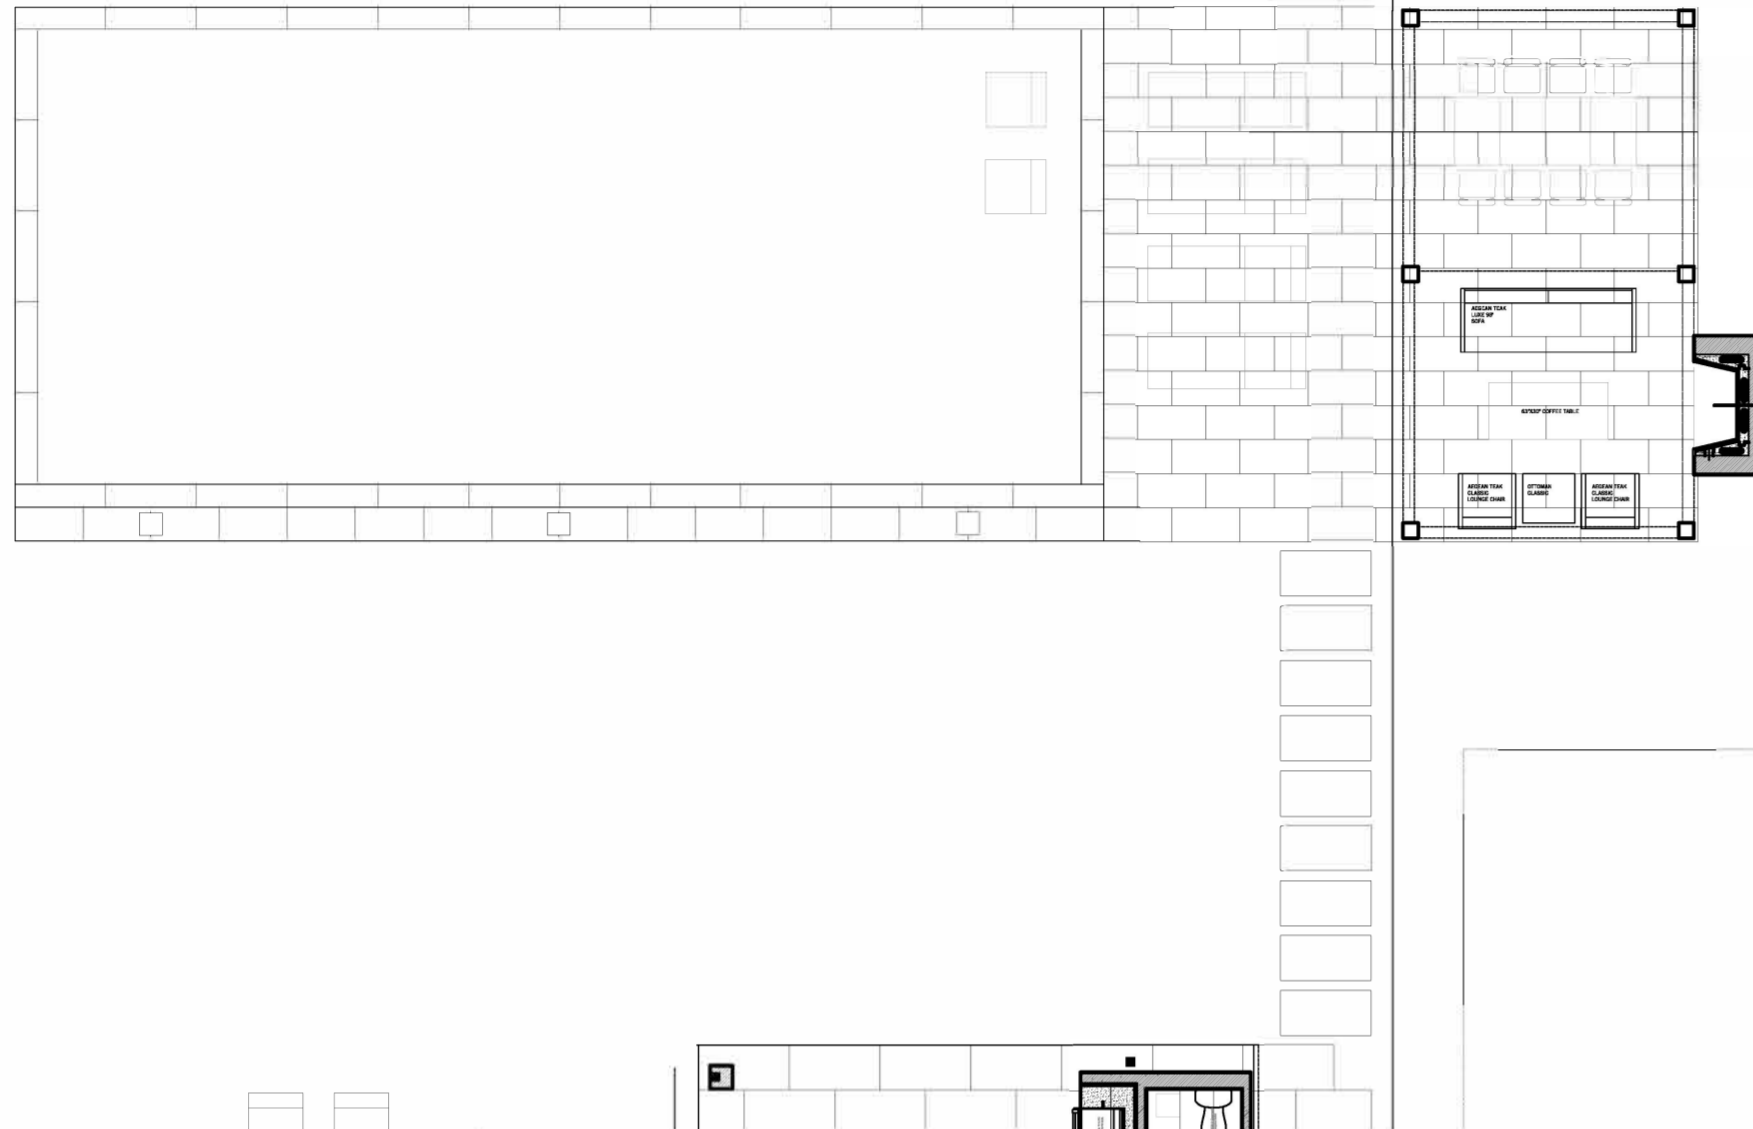

2

FIRST FLOOR


SCALE 1/16"=1'

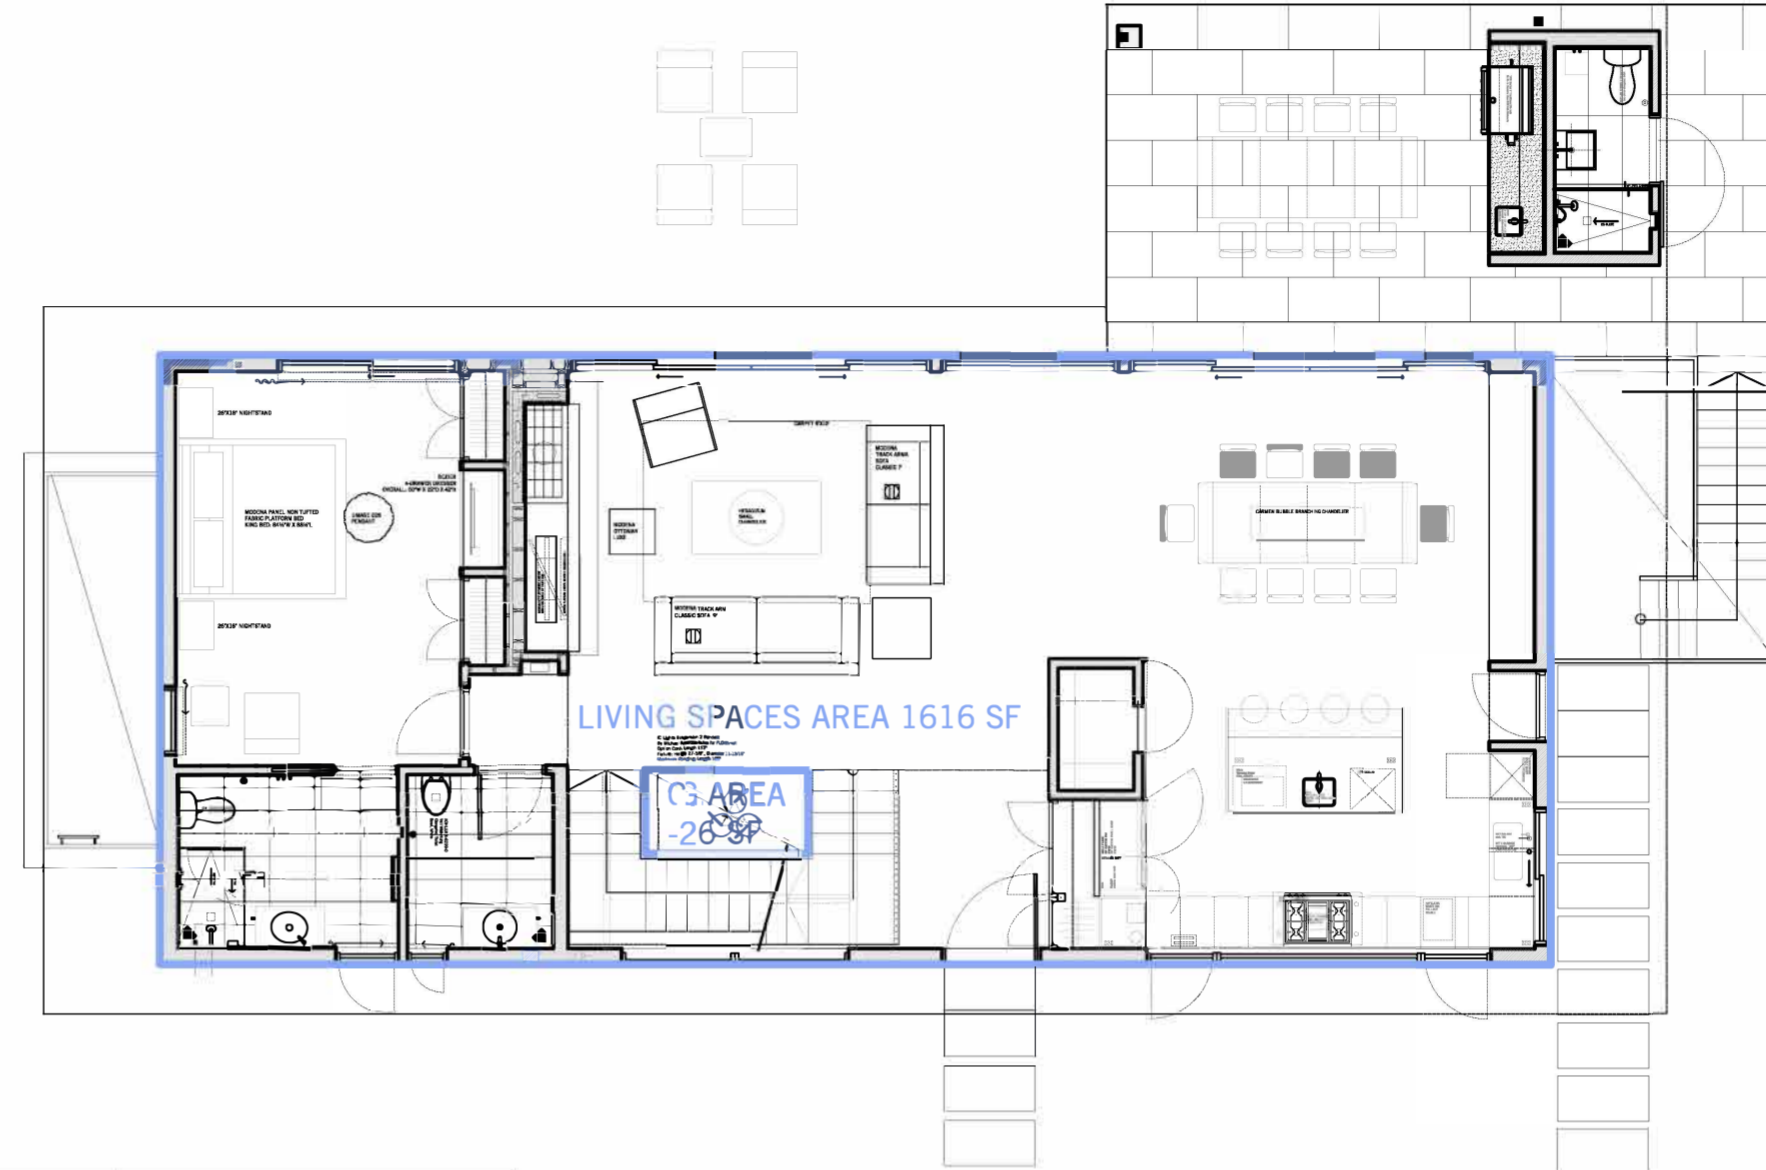

4

BASEMENT


SCALE 1/16"=1'

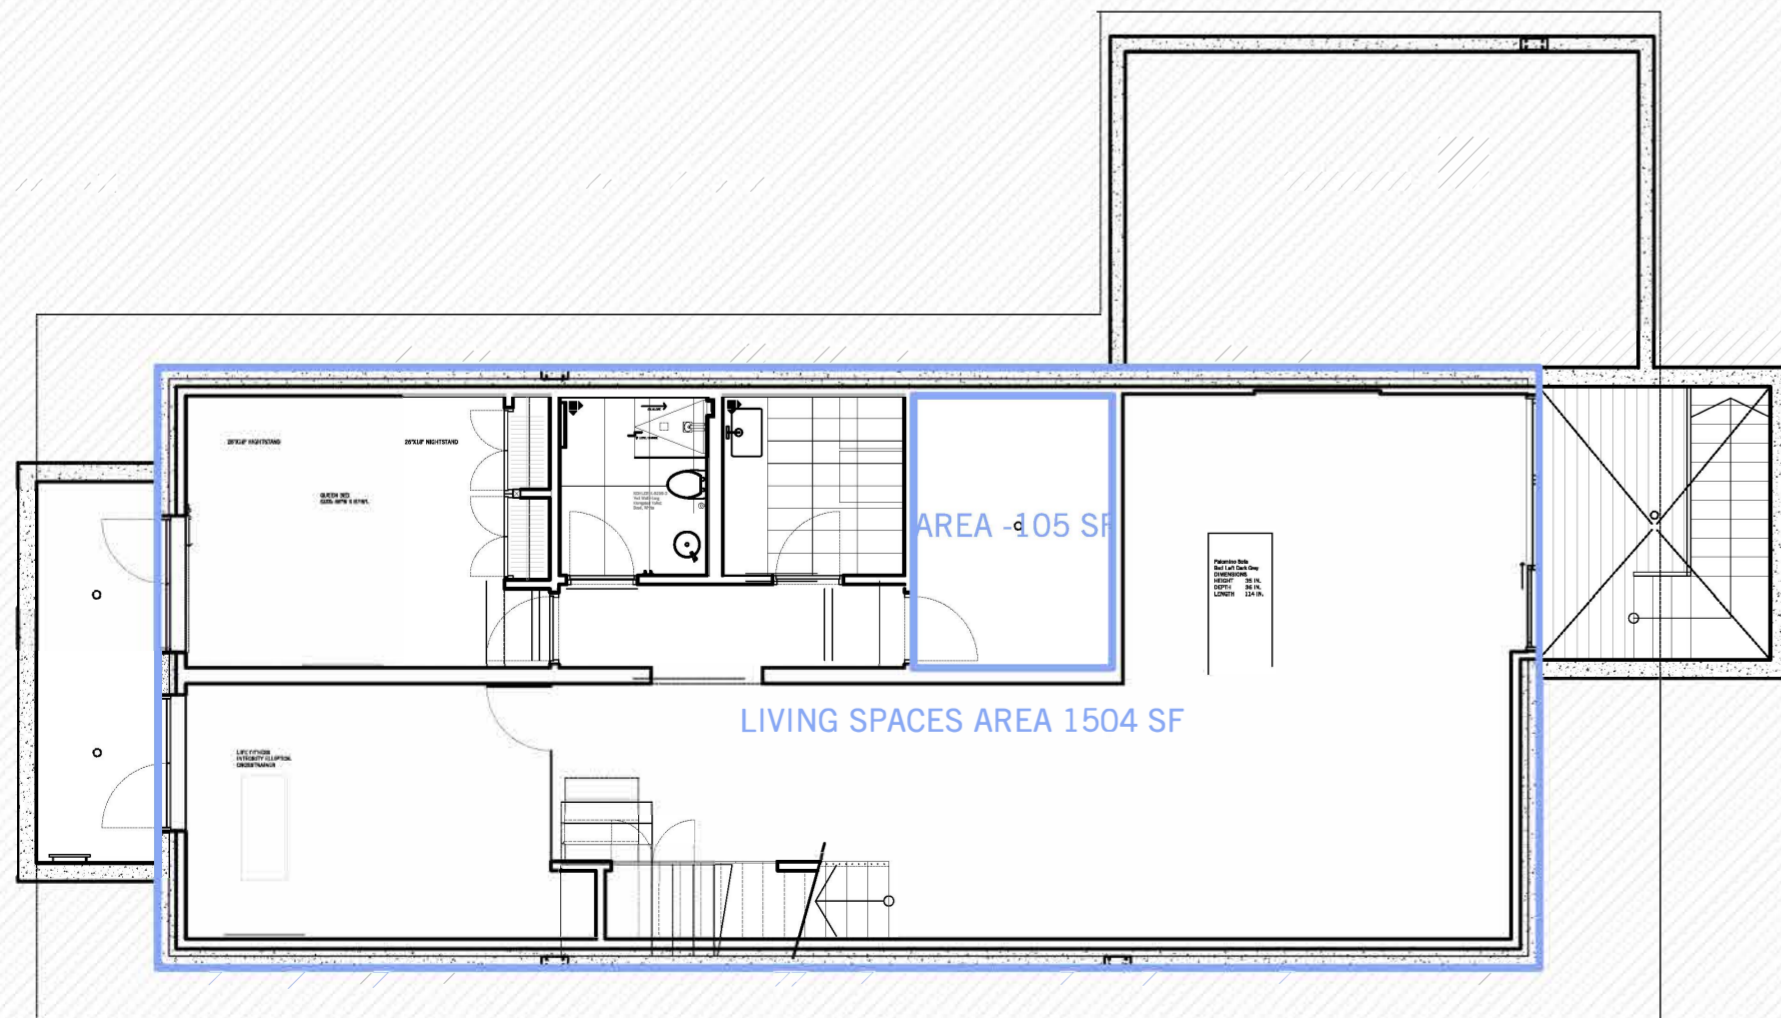

3

SECOND FLOOR

SCALE 1/16"=1'

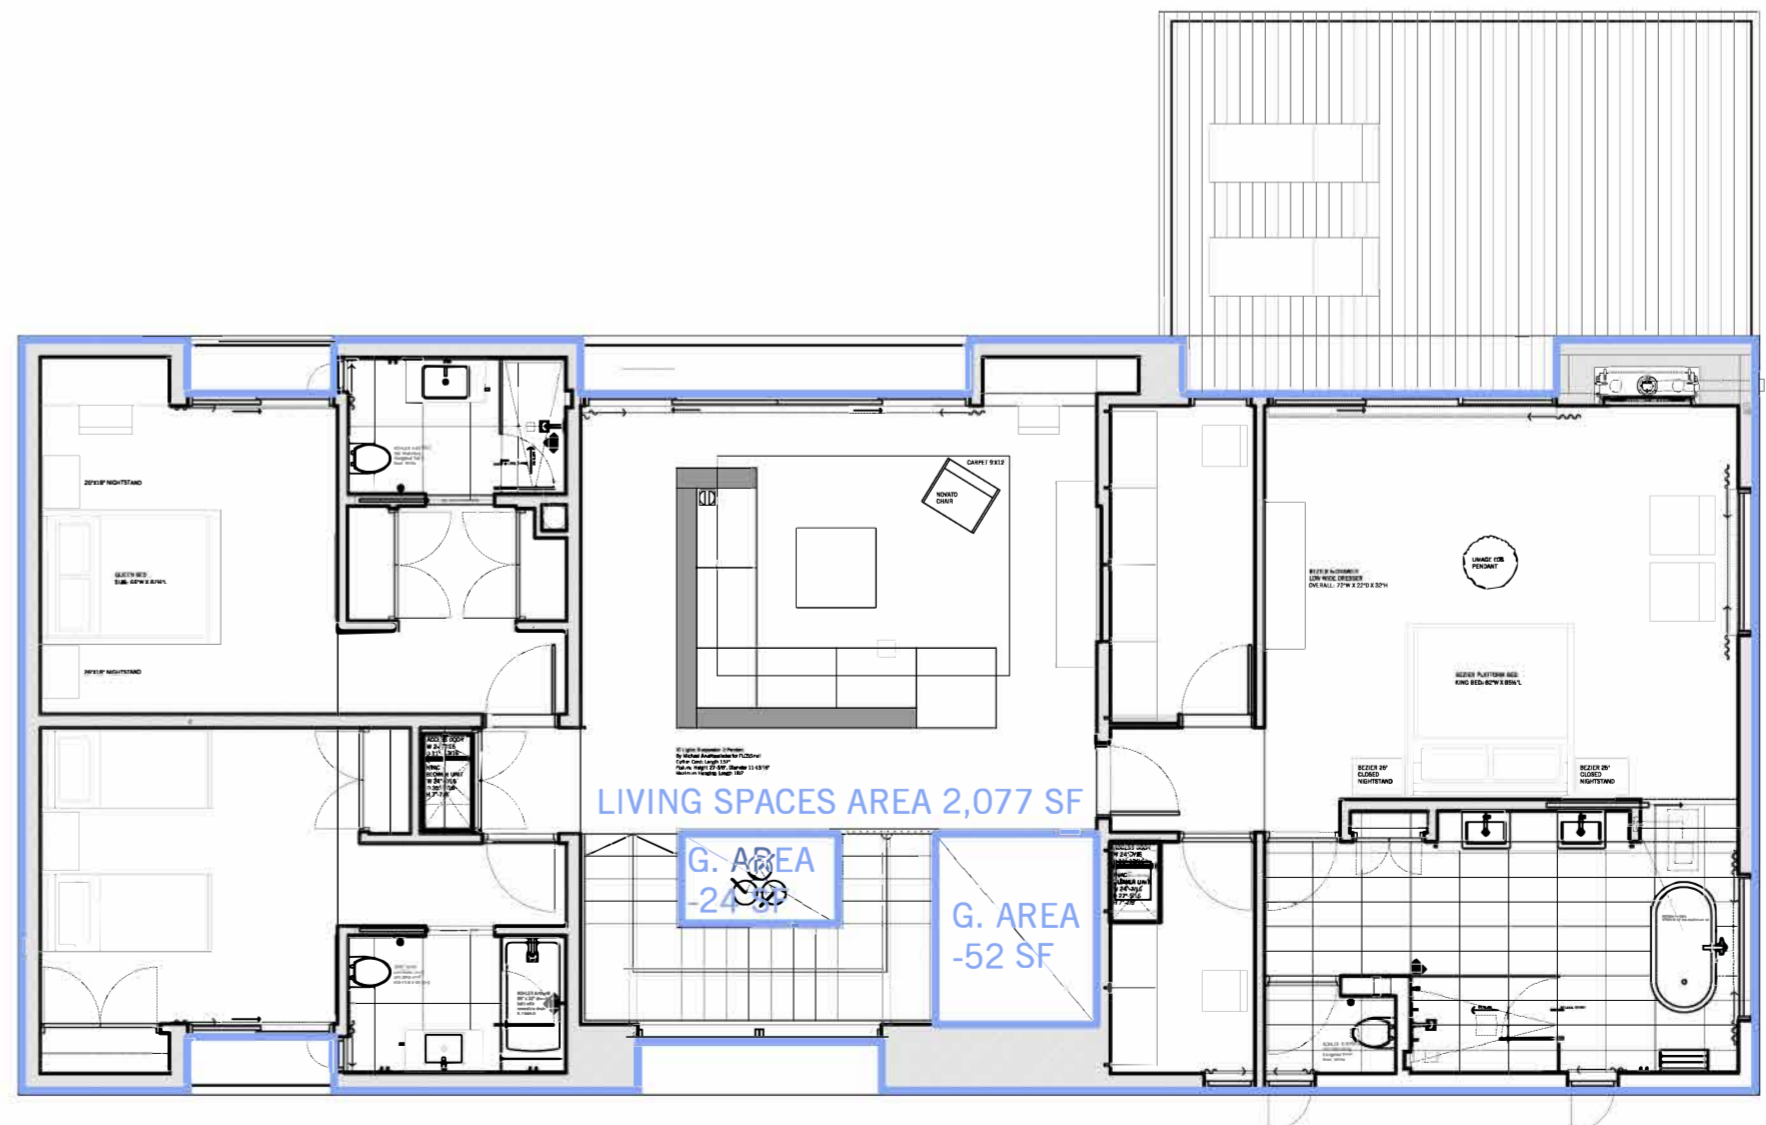

Southampton, New York

M. ARCH. DIEGO PETRATE

Cantilo 1042, 1896 City Bell, Argentina  
T +54 221.4720845 E info@diegopetrato.net  
Architect

SUMMARY OF FLOOR PLAN AREAS

Executive Architect

A2-1.1

1/2"=1'

Drawing Title

Drawing Number

Scale  
2015-002  
Project Number

01	schematic design issue	03.05.2018
02	FOR CONSTRUCTION	02.09.2019
03	AS BUILT	02.16.2024

Number	Description	Date

SUMMARY OF LIVING SPACES AREAS

BASEMENT	1,504 SF
FIRST FLOOR	1,616 SF
SECOND FLOOR	2,077 SF
<b>TOTAL LIV. SPACES</b>	<b>5,197 SF</b>